
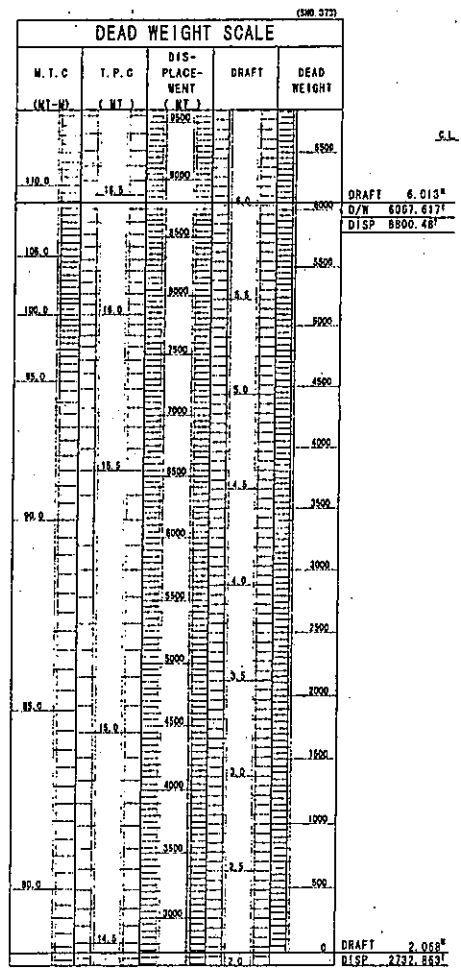


NOTE
 24th FEB. 2003 資料において作成する
 23th MAY. 2003 完成図として掲載する

PRINCIPAL PARTICULARS

LENGTH (P.P)	104.50
BREADTH (MLD)	18.20
DEPTH (MLD)	9.80
DRAFT (SUMMER EXT.)	6.00

CAPACITY PLAN

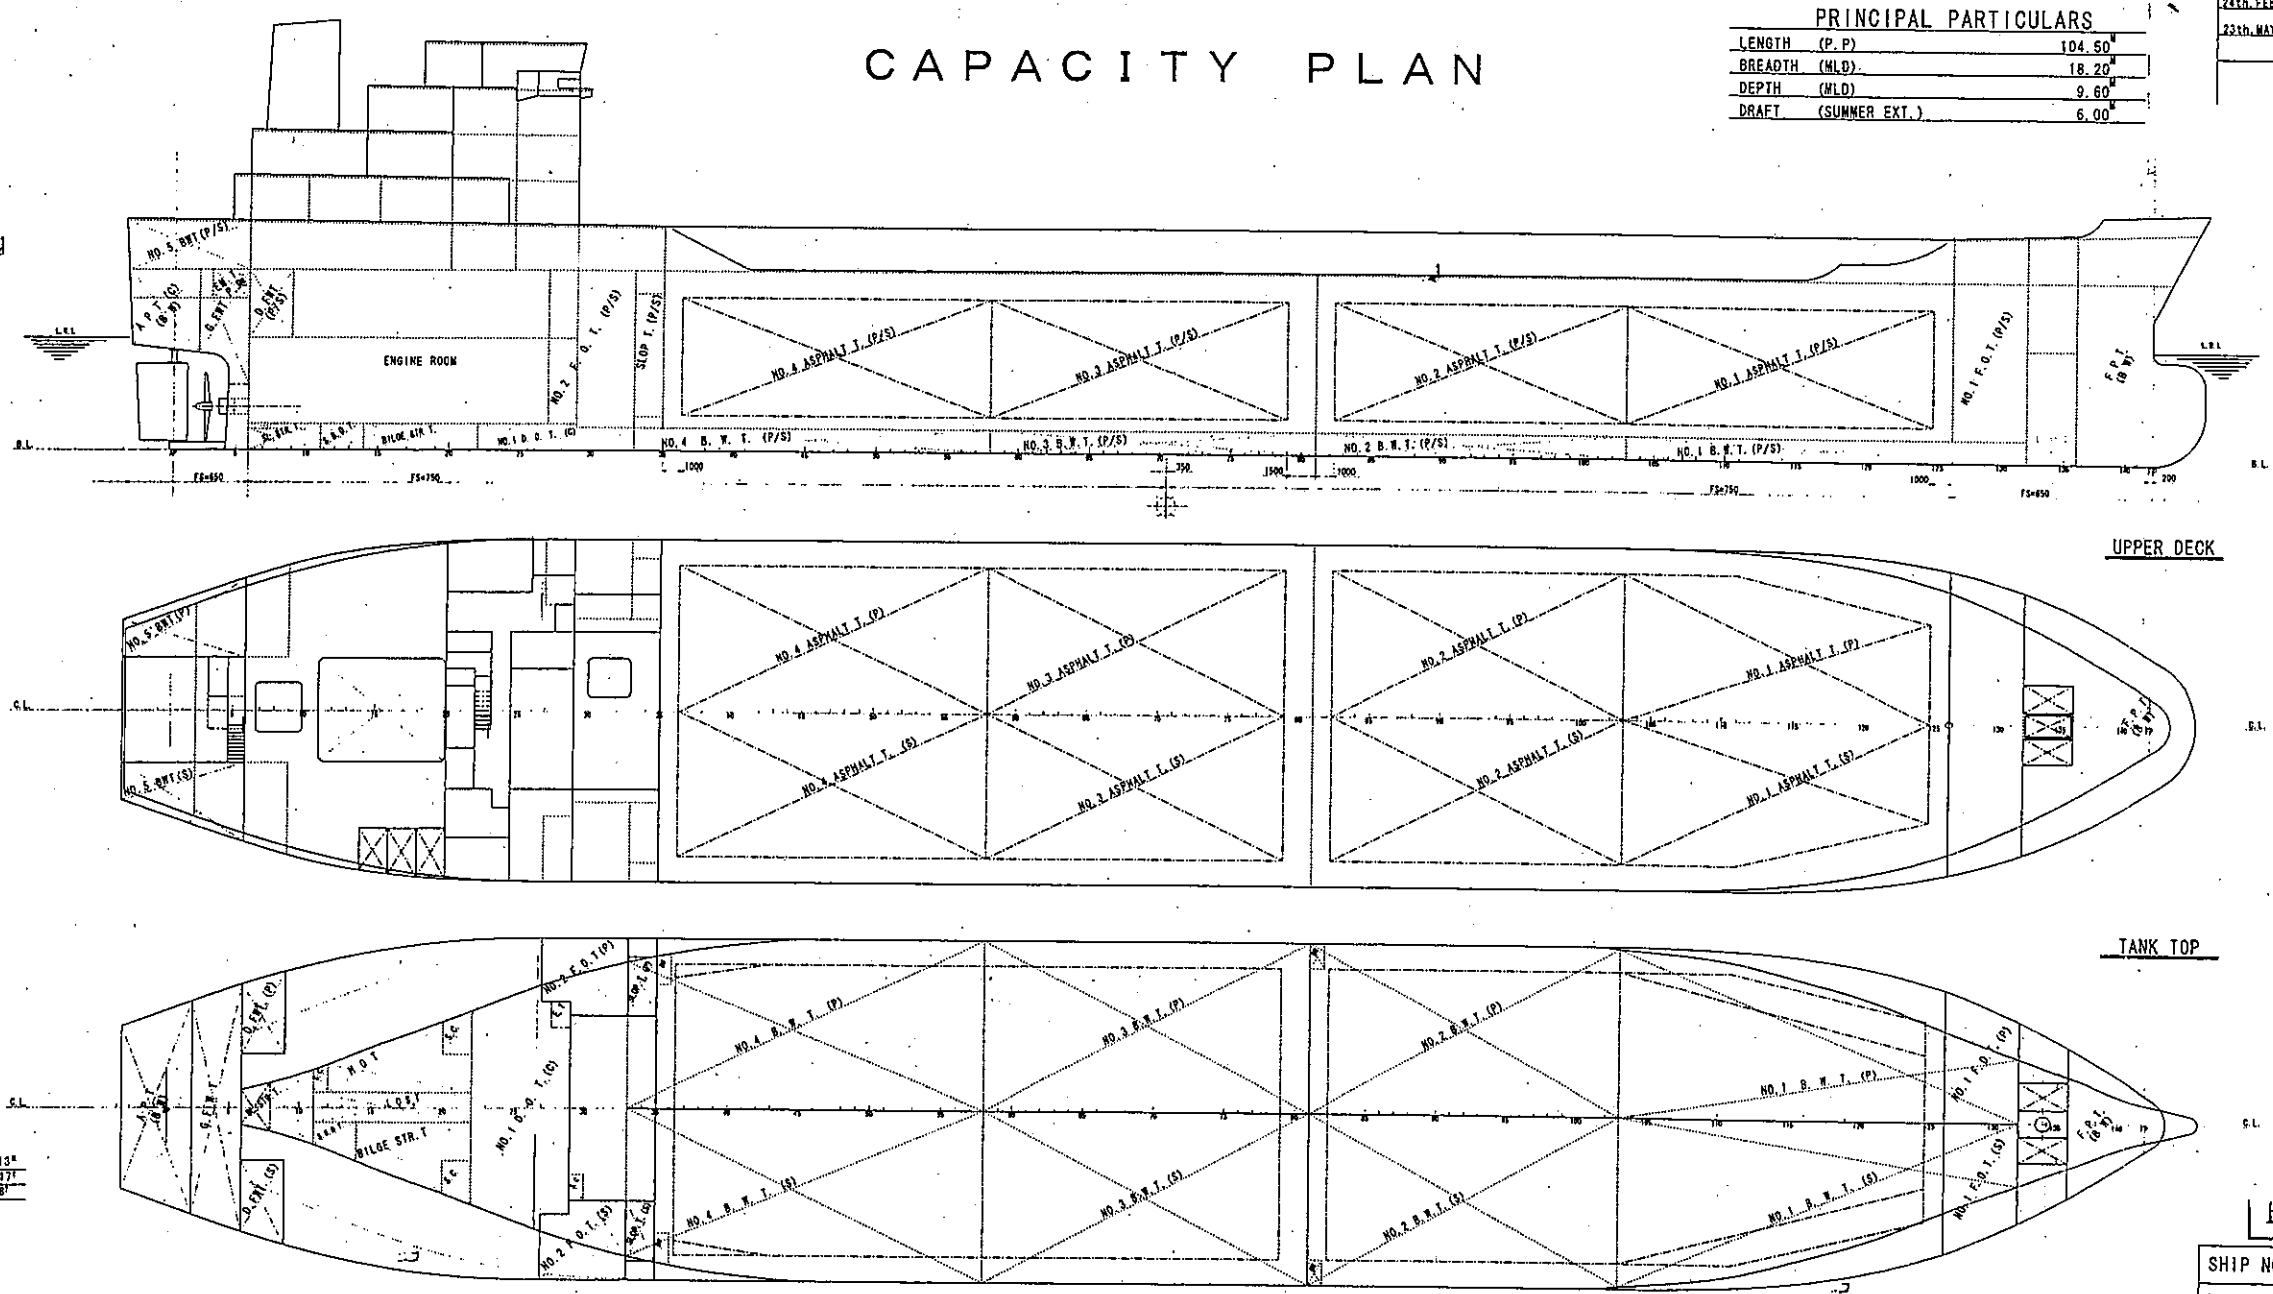

TANK	Location Fr. No.	Volume (m³)	LCG (m)	KG (t)	I _{max} (m²)	
NO. 1 ASPHALT T.	P 102 - 124a	659.912	1243.017	-31.80	5.44	488.8
	S 103 - 124a	673.105				
NO. 2 ASPHALT T.	P 82a - 103	766.223	1529.874	-16.65	5.30	588.8
	S 82a - 103	763.651				
NO. 3 ASPHALT T.	P 58 - 79	776.456	1551.531	1.40	5.30	598.5
	S 58 - 79	775.075				
NO. 4 ASPHALT T.	P 36a - 58	789.028	1598.277	17.47	5.31	617.5
	S 36a - 58	804.240				
total		6023.699	6022.599			

TANK	Location Fr. No.	Volume (m³)	LCG (m)	KG (t)	I _{max} (m²)	
SLOP T.	P 33 - 35	26.316				
	S 33 - 35	26.316	27.350	5.804	4.10	
total		52.632				

TANK	Location Fr. No.	Volume (m³)	LCG (m)	KG (t)	I _{max} (m²)	
F.P.T.	C 132 - 146	295.688	295.596	-49.487	8.121	745.90
	P 103 - 132	128.187				
	S 103 - 132	128.187	252.374	-32.807	0.659	530.35
NO. 1 B.W.T.	P 81 - 103	157.491				
	S 81 - 103	157.491	324.982	-15.968	0.625	979.95
NO. 2 B.W.T.	P 58 - 81	181.718				
	S 58 - 81	181.718	363.432	0.726	0.621	1078.10
NO. 3 B.W.T.	P 33 - 58	180.084				
	S 33 - 58	180.084	360.168	18.229	0.631	1022.40
NO. 4 B.W.T.	P -4 - 6	46.508				
	S -4 - 6	46.508	93.016	51.033	11.035	20.98
NO. 5 B.W.T.	P -4 - 2	72.768				
	S -4 - 2	72.768	72.768	52.512	7.617	245.29
A.P.T.	G		1772.336	1772.336		
total						

TANK	Location Fr. No.	Volume (m³)	Volume (t)	LCG (m)	KG (t)	I _{max} (m²)
NO. 1 F.O.T.	P 128 - 132	150.375				
	S 128 - 132	150.375	300.750	-43.479	5.882	74.16
NO. 2 F.O.T.	P 27 - 33	124.425				
	S 27 - 33	124.425	248.850	30.172	5.947	24.33
total		274.800	549.600			

TANK	Location Fr. No.	Volume (m³)	Volume (t)	LCG (m)	KG (t)	I _{max} (m²)
NO. 1 D.O.T.	C 22 - 33	98.597				
	S 22 - 33	98.597	197.194	31.785	0.716	1063.55
total		197.194				

TANK	Location Fr. No.	Volume (m³)	Volume (t)	LCG (m)	KG (t)	I _{max} (m²)
G.F.W.T.	C 2 - 6	83.384	83.384	49.576	7.510	361.88
	P 5 - 9	26.509				
	S 5 - 9	26.509	53.018	47.178	8.100	13.40
D.F.W.T.	S 6 - 9	26.509				
	S 6 - 9	26.509	53.018	47.178	8.100	13.40
total		136.402	136.402			

TANK	Location Fr. No.	Volume (m³)	Weight (t)	LCG (m)	KG (t)	I _{max} (m²)
L.O.S.T.	C 11 - 22	11.260				
	S 11 - 22	11.260	22.520	40.452	0.453	2.61
BILGE STR. T.	S 14 - 22	11.849				
	S 14 - 22	11.849	23.698	39.178	0.810	5.01
H.O.T.	P 12 - 22	13.264				
	S 12 - 22	13.264	26.528	39.590	0.819	5.50
S.B.D.T.	S 11 - 14	1.861				
	S 11 - 14	1.861	3.722	43.318	0.865	0.22
SL. STR. T.	G 8 - 11	7.151				
	G 8 - 11	7.151	14.302	46.068	0.743	2.33

FINAL PLAN

SHIP NO	SNO 373
NAME OF OWNER	RINA SHIPPING CO., LTD
NAME OF SHIP	NEW MILLENNIUM
KIND OF SHIP	ASPHALT TANKER

D/W 6000* TYPE

CAPACITY PLAN

(容積図)

SCALE	1/200
-------	-------

ND
 KURINOURA DOCKYARD CO., LTD
 YAWATAHAMA JAPAN

DRAWN BY	H.K.
CHECKED BY	
CHIEF OF PART	
CHIEF OF SECT	
DATE	FEB. 25, 2003
DRWG. NO.	F - 1